



MAP OF SURVEY
CERTIFICATE OF AUTHORIZATION L.B. 7426

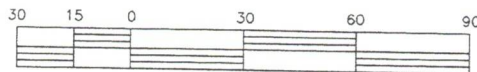

SCALE IN FEET
1 INCH = 30 FEET

LEGAL DESCRIPTION:

PART OF THE N.E. 1/4 OF SECTION 32, TOWNSHIP 27 SOUTH, RANGE 37 EAST, BREVARD COUNTY, FLORIDA,
BEING MORE PARTICULARLY DESCRIBED AS FOLLOWS:

FROM THE S.E. CORNER OF SAID N.E. 1/4 OF SECTION 32, RUN S89°18'33"W ALONG THE SOUTH LINE OF SAID N.E. 1/4 A DISTANCE OF 612.31 FEET; THENCE N00°41'27"W A DISTANCE OF 100.00 FEET TO THE NORTH RIGHT OF WAY LINE OF NASA BOULEVARD; THENCE NORTHWESTERLY ALONG A CURVE WHICH IS CONCAVE EASTERLY, HAVING A RADIUS OF 25.00 FEET AND A CENTRAL ANGLE OF 90°00'00", AN ARC DISTANCE OF 39.27 FEET TO A POINT OF TANGENCY; THENCE N00°41'27"W, ALONG THE EAST LINE OF A 90.00 FEET WIDE DESIGNATED RIGHT OF WAY OF GRUMMAN PLACE A DISTANCE OF 695.00 FEET TO AN ANGLE POINT IN SAID RIGHT OF WAY; THENCE S89°18'33"W ALONG THE NORTHERLY LINE OF A DESIGNATED 170.00 FEET WIDE RIGHT OF WAY FOR GRUMMAN PLACE, A DISTANCE OF 540.05 FEET TO THE EAST LINE OF DESIGNATED 100.00 FEET WIDE RIGHT OF WAY FOR TOWER ACCESS ROAD; THENCE N07°58'50"W ALONG SAID EAST RIGHT OF WAY LINE A DISTANCE OF 201.63 FEET TO AN ANGLE POINT; THENCE S89°18'33"W A DISTANCE OF 20.16 FEET; THENCE N07°58'50"W, ALONG THE EAST RIGHT OF WAY LINE OF THE DESIGNATED 80.00 FEET WIDE RIGHT OF WAY FOR TOWER ACCESS ROAD, A DISTANCE OF 172.56 FEET TO THE POINT OF BEGINNING OF THE HEREIN DESCRIBED PARCEL; THENCE N07°58'50"W ALONG SAID EAST RIGHT OF WAY LINE OF TOWER ACCESS ROAD A DISTANCE OF 231.08 FEET; THENCE N78°30'58"E A DISTANCE OF 223.75 FEET; THENCE S23°37'00"E A DISTANCE OF 250.00 FEET; THENCE S81°13'49"W A DISTANCE OF 290.74 FEET TO THE POINT OF BEGINNING.

CONTAINS 1.3988 ACRES (60,932 SQUARE FEET), MORE OR LESS.

CERTIFIED TO: DR. GOPAL GADODIA; BUILDING MANAGEMENT SYSTEMS

THIS SURVEY DOES NOT REFLECT OR DETERMINE OWNERSHIP
© COPYRIGHT 2012 SMITH & ASSOCIATES SURVEYING AND MAPPING, INC.
NOT VALID WITHOUT THE SIGNATURE AND THE ORIGINAL RAISED SEAL OF
A FLORIDA LICENSED SURVEYOR AND MAPPER

SURVEYORS NOTES:

- LANDS SHOWN HEREON WERE NOT ABSTRACTS FOR ADJOINING DEEDS, RIGHT-OF-WAY, RESERVATION, AGREEMENTS AND/OR EASEMENTS OF RECORD. SUCH INFORMATION, IF DESIRED, SHOULD BE OBTAINED AND CONFIRMED BY OTHERS THROUGH APPROPRIATE TITLE VERIFICATION.
- ADJOINING SHOWN HEREON HAVE NOT BEEN RECORDED.
- DRAWINGS ARE NOT TO BE RELIED UPON FOR SCALE PURPOSES.
- ALL MEASUREMENTS ARE IN FEET AND DECIMAL PARTS THEREOF AND ARE IN ACCORDANCE WITH THE STANDARDS OF THE UNITED STATES (CHAPTER 5117-6.003(1)(B) F.A.C.)
- FLORIDA LAND SURVEYING BOARD (F.A.C. 5117-6.003, 003(17)) THIS SURVEY IS BASED ON A CLOSED TRVERSE.
- USE ONLY A PRACTICE CORNERS FOR CONSTRUCTION OF FENCES AND OTHER IMPROVEMENTS.
- ONLY OPEN AND NOTORIOUS EVIDENCE OF EASEMENTS AND RIGHT-OF-WAYS ARE LOCATED AND SHOWN AS SHOWN AND ARE NOT LOCATED ANY UNDERGROUND UTILITIES OR FOUNDATIONS WHICH MAY ENCROACH.
- LEGAL DESCRIPTION AS SHOWN WAS PROVIDED VERBALLY BY CLIENT.
- ELEVATIONS BASED ON 50.00' ASSUMED AT N/A
- ELEVATIONS BASED ON NORTH AMERICAN VERTICAL DATUM OF 1988 (PARSNT B.M. 5609)
- ELEVATION OF SURFACE OF LAND EXPRESSED IN FEET AND DECIMAL PARTS THEREOF.
- BEARINGS BASED ON SOUTH LINE OF NE 1/4 OF SEC. 32 BEING 88°19'33" (ASSUMED)
- PLOT PLANS ARE NOT TO BE USED FOR CONSTRUCTION LAYOUT PURPOSES.
- LOT DIMENSIONS AND BEARINGS ARE RECORD AND MEASURED UNLESS OTHERWISE NOTED.
- SEPTIC TANKS AND WELLS IF SHOWN ARE APPROXIMATE LOCATIONS AND SHOULD BE FIELD VERIFIED FOR EXISTENCE, DEPTH, CONSTRUCTION AND SEPARATION.
- NORTH ARROW AS SHOWN DOES NOT REPRESENT TRUE NORTH OR GRID NORTH, IT IS FOR APPROXIMATE POSITION ONLY.
- ALL RIGHT-OF-WAYS, ALLEYS, DIRT ROADS, AND ASPHALT ROADS IF SHOWN ARE "OPEN TO TRAFFIC" AND ARE NOT TO BE MEASURED UNLESS OTHERWISE NOTED BY (CLOSED TO TRAFFIC).
- SETBACKS AS SHOWN ON PLOT PLANS WERE PROVIDED BY CONTRACTOR.
- HORIZONTAL FEATURE ACCURACY: TOPOGRAPHIC LAND FEATURES (SIGNS, LINES, VALUES, MARKERS, POWER POLES, DRIVWAYS, CULVERTS, AND SIMILAR FEATURES) HAVE A HORIZONTAL FEATURE ACCURACY OF PLUS OR MINUS 0.25 FEET.
- VERTICAL FEATURE ACCURACY: ELEVATIONS ON THE SITE (GROUND, PAVEMENT, INLETS, ETC.) WAS MEASURED BY THE SURVEYOR USING A TOTAL STATION WITH AN ELECTRONIC TOTAL STATION READING DIRECTLY TO A MINIMUM OF 5 SECONDS PER ANGLE WITH A DISTANCE ACCURACY OF PLUS OR MINUS 50.000. ALL DATA WAS RECORDED USING A FIELD DATA COLLECTOR AND THE DATA WAS FIELD CHECKED FOR ACCURACY. THE DATA WAS NOT RECORDED USING A CLOSED CONVENTIONAL FIGURE AND ANY DATA SHOTS WERE DONE USING A REDUNDANCY OF MEASUREMENT.
- ALL EQUIPMENT USED IN PERFORMING THE FIELD WORK ASSOCIATED WITH THIS SURVEY WAS TESTED AND CALIBRATED PRIOR TO THE SURVEY.

LEGEND:

N.V.W. = NO VISIBLE WELL
P.C. = PERMANENT CONTROL POINT
P.O.C. = POINT OF COMMCNCEMENT
O.B. = BEGINNING
P.T. = POINT OF TANGENCY
P.R.M. = PERMANENT REFERENCE MONUMENT
P.S. = POINT OF SIGHT
P.C. = POINT OF CURVATURE
P.C.C. = POINT OF COMPOUND CURVATURE
R = RADIUS OF RADIUS OF CURVATURE
D.C. = DELTA (CENTRAL ANGLE)
R = RADII
T = TANGENT
S = CENTERLINE
F = PROPERTY LINE
W = WOOD
M = MEASURED
W = WOOD FRAME
C = CALCULATED
R/Y = RIGHT-OF-WAY
D = DISTANCE
L.D. = NO IDENTIFICATION MORE OR LESS
C.B.S. = CONCRETE BLOCK & STUCCO
F & L = FLUID POWER AND LIGHT
R = RADIUS
PROP. = PROPOSED
TR. = TRANSFORMER
C.B.C. = CONCRETE
APPX. = APPROXIMATE (TYP. = TYPICAL)
E.O.P. = EDGE OF PAVEMENT
T.O.S. = TOP OF SURFACE
E.O.W. = APPROX. EDGE OF WATER

T.O.B. = APPROX. TOP OF BANK
N.T.S. = NOT TO SCALE
O/S = OFFSET
L.F.E. = LOWEST FLOOR ELEVATION
F.F.E. = FINISHED FLOOR ELEVATION
O.F. = OFFICIAL RECORDS BOOK
P.B. = PLASTIC BULK
D.B. = DEED BOOK
P.C. = PLASTIC
P.V.C. = POLYVINYLCHLORIDE
C.M.P. = CORRUGATED METAL PIPE
C.C.P. = REINFORCED CONCRETE PIPE
C.P.P. = CORRUGATED PLASTIC PIPE
INV. = INVERT
W. = WATER METER
E. = ELECTRIC METER/HANDHOLE
S. = SANITARY SEWER MANHOLE
ST. = STORM SEWER MANHOLE
S.M. = SOUTHERN BELL MANHOLE/HANDHOLE
U. = UNDER MAIN ROAD
S. = SOUTHERN BELL RESER
C. = CALIF. TELEVISION RESER
M. = GAS VALVE.

- = REGULAR WATER METER
- = GAS SERVICE
- = WATER VALVE IN 2" x 2" CONC.
- = WATER VALVE
- = FIRE HYDRANT
- = POWER POLE
- = LIGHT POLE
- = GUY ANCHOR
- = FENCE
- = OVERHEAD WIRE (D.H.W.)
- = APPROXIMATE SEPTIC TANK
- = IRON MARKER FOUND - SEE DESCRIPTION
- = 1/2" IRON ROD WITH PLASTIC GUY
- "A.C. SMITH 1/2 7428" SEE (CHAPTER 0116.0031(2)(20) F.A.C.)
- = 4" x 4" CONC. MONUMENT FOUND - SEE DESCRIPTION
- = 4" x 4" CONC. MONUMENT MARKED
- "A.C. SMITH 1/2 7428" SEE (CHAPTER 0116.0031(2)(20) F.A.C.)
- = 4" x 4" CONC. MONUMENT MARKED
- "A.C. SMITH 1/2 7428" SEE (CHAPTER 0116.0031(2)(20) F.A.C.)
- = WALL & DISK MARKED
- "A.C. SMITH 1/2 7428" SEE (CHAPTER 0116.0031(2)(20) F.A.C.)
- = HUB & TAPK. SEE

PROPERTY ADDRESS: 805 TOWER ACCESS ROAD
MELBOURNE, FLORIDA 32902

TYPE	SURVEY DATE	JOB NUMBER	CK. BY
AS-BUILT SURVEY	JUNE 15, 2012	12-0954 ~ 11-0236.DWG	
DRAWN BY: A. TEJADA		SCALE: 1" = 30'	

DRAWN BY: A. TEJADA

SCALE: 1" = 30'

PROFESSIONAL SURVEYOR & MAPPER IN RESPONSIBLE CHARGE
KEVIN A. SMITH - FLORIDA CERTIFICATE NO. 4457
ANDREW J. SMITH - FLORIDA CERTIFICATE NO. 5690